



FILE INFO: F:\Sector833\Projects\DET-00015687-A0 Livonia MW Hq. DET Energy New Service\1172\1172a102.dwg  
 XREFS: MODIFIED: Mar 02, 2012 9:46am  
 PLOTTED: Mar 02, 2012 10:05am BY: luvrsh Plot SCALE: 1/8"=1'-0"

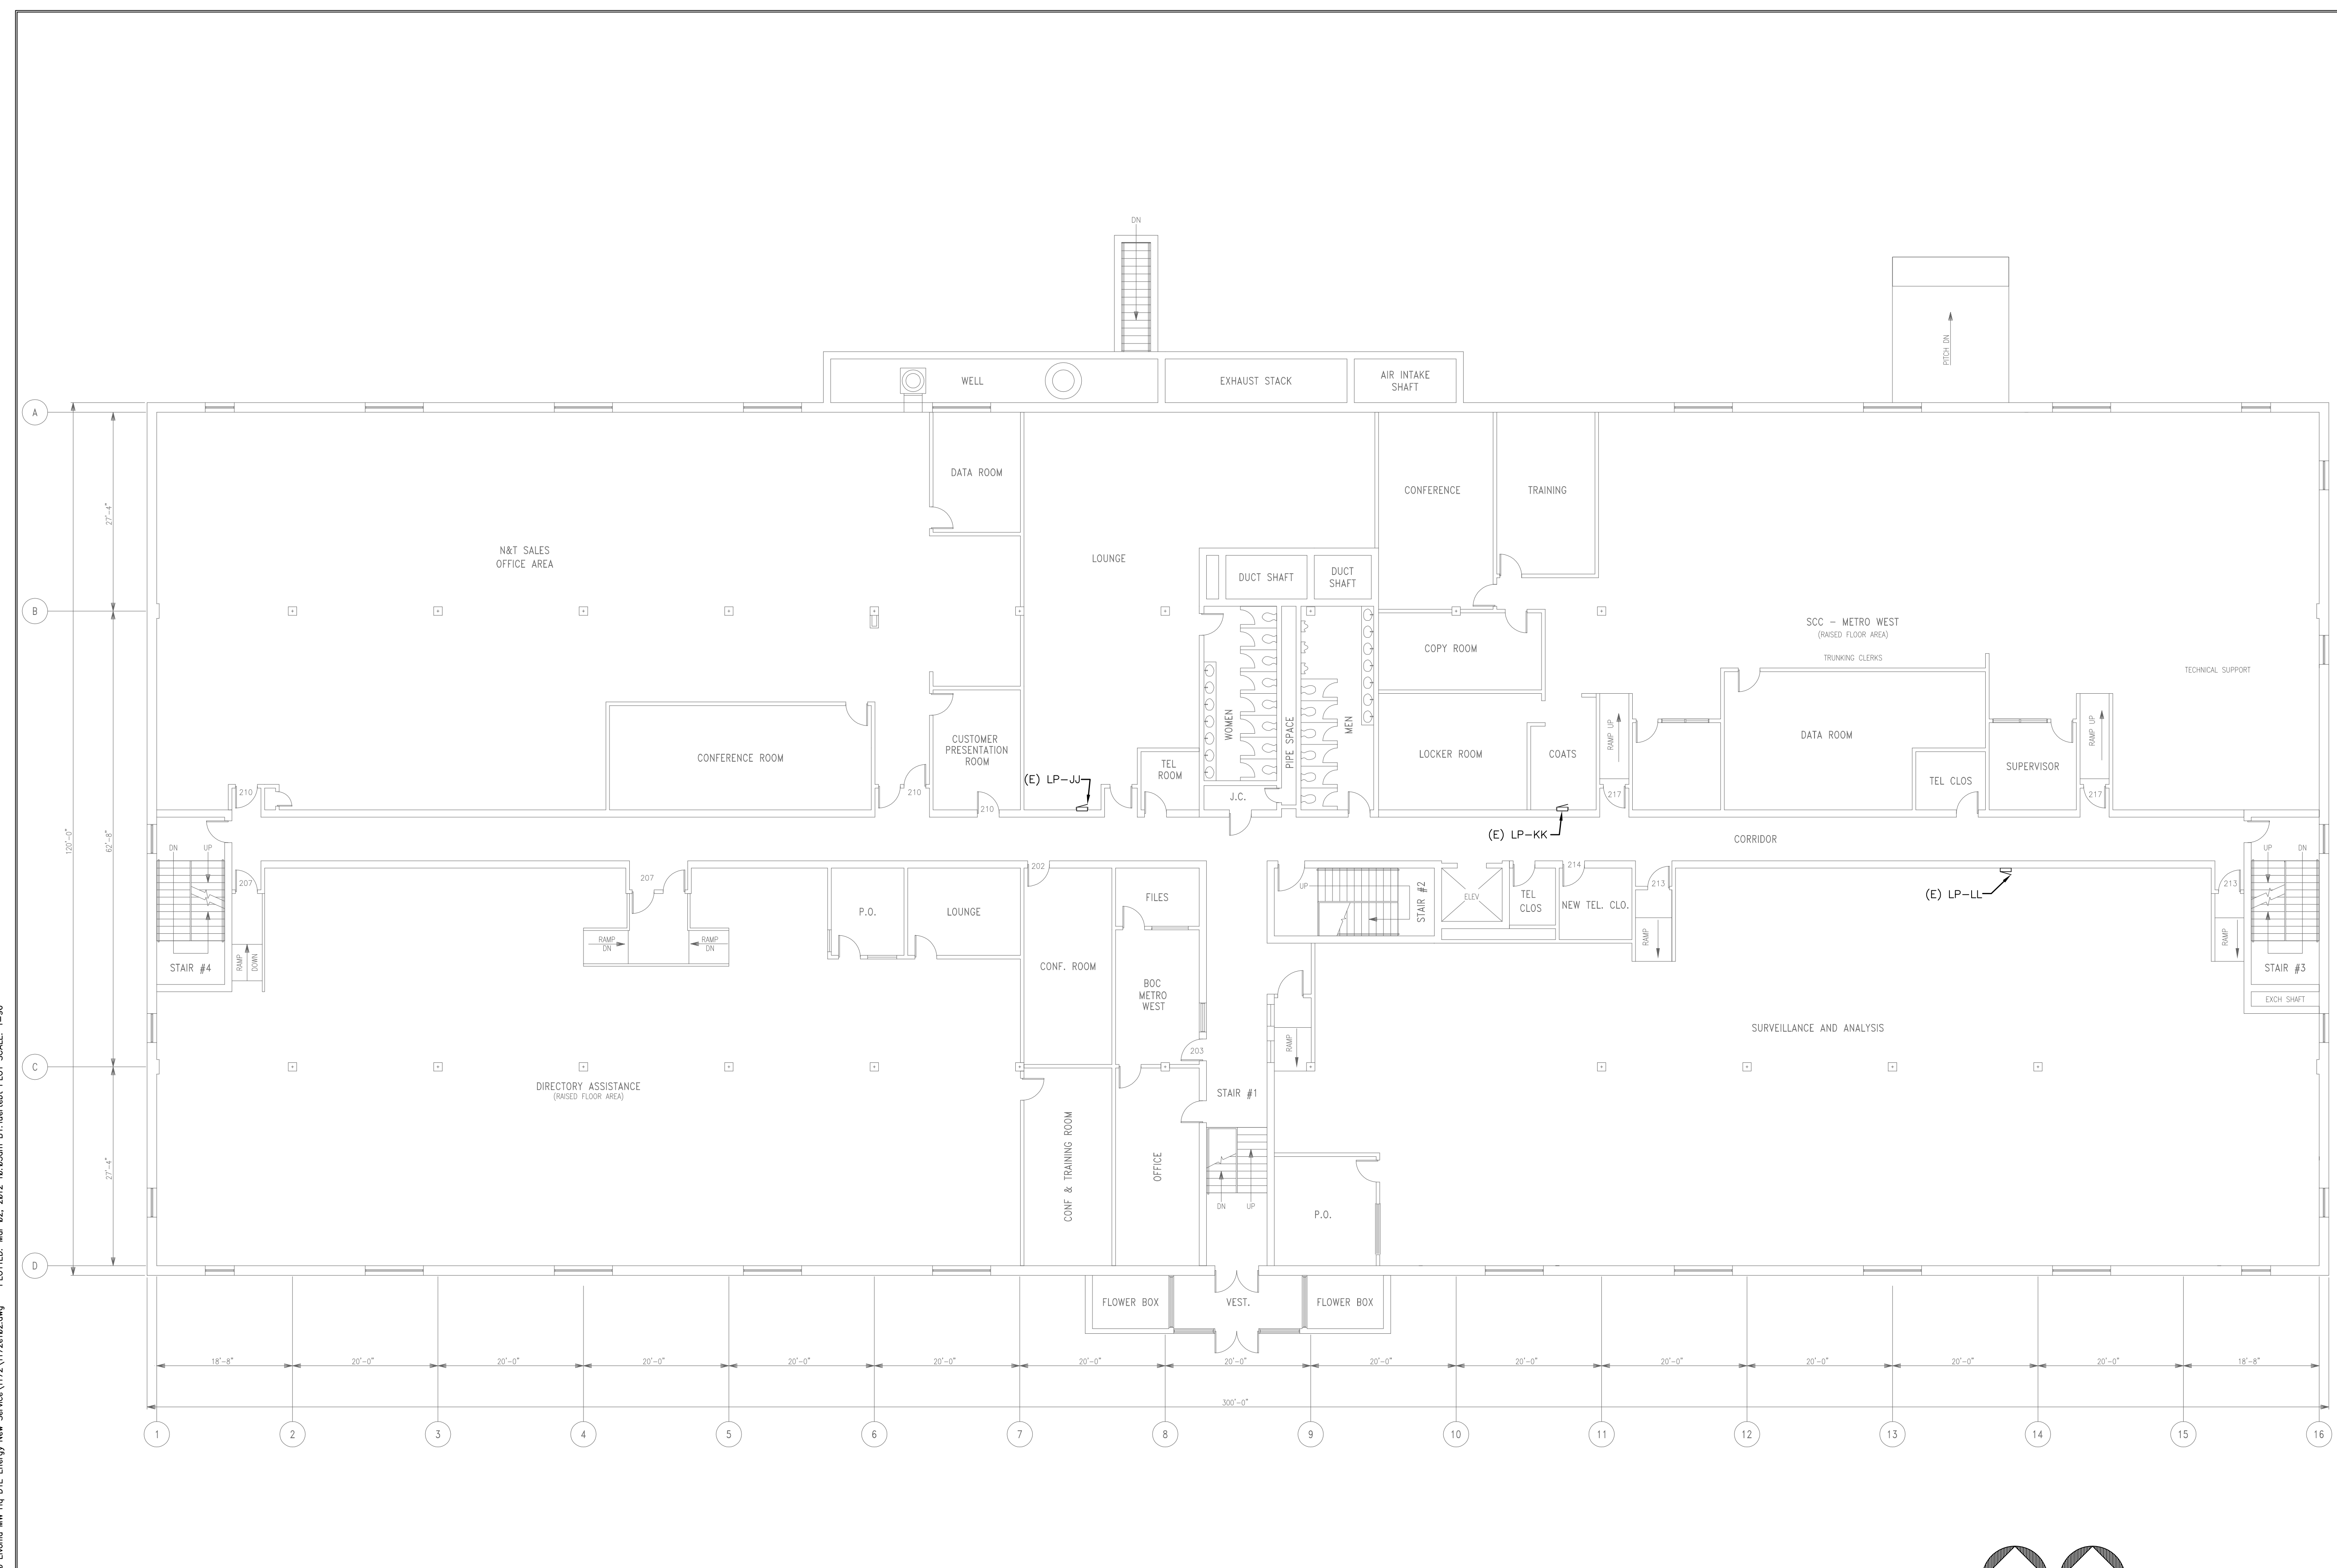

**MID LEVEL FLOOR PLAN**  
 SCALE: 3/32" = 1'-0"

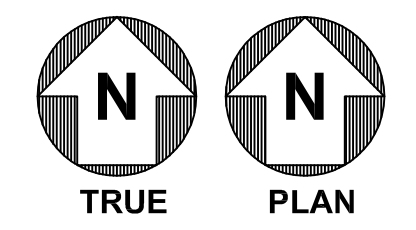

ISSUE DATE:	11/29/07
FOR:	RECORD DRAWINGS
ISSUED BY:	C&B
ISSUE DATE:	4/18/07
FOR:	REVISION #2
ISSUED BY:	K.T.
ISSUE DATE:	4/09/07
FOR:	REVISION #1
ISSUED BY:	K.T.
ISSUE DATE:	3/13/07
FOR:	ADDENDUM #1
ISSUED BY:	MJN
ISSUE DATE:	12/21/06
FOR:	MDEQ SUBMITTAL
ISSUED BY:	K.T.

CONSULTANT STAMP


**Carter Burgess**  
 CARTER & BURGESS CONSULTANTS, INC.  
 30800 TELEGRAPH RD., SUITE 4900  
 BINGHAM FARMS, MICHIGAN 48025

**C&B JOB NUMBER:**  
 371172

REVISIONS / AUTHORIZATIONS			
NO.	REVISIONS / AUTHORIZATIONS	DATE	BY
1	85% REVIEW	12/8/06	K.T.
2	OWNER REVIEW	12/15/06	K.T.
3	OWNER REVIEW	02/15/07	K.T.
4	CONSTRUCTION	02/22/07	K.T.

**PROPRIETARY AT&T INFORMATION**  
 NOT FOR GENERAL USE OR DISCLOSURE OUTSIDE OF AT&T  
 THIS INFORMATION MAY ONLY BE USED BY AUTHORIZED PERSONNEL OF  
 THE LOCAL GOVERNMENT AGENCY IN CONNECTION WITH APPLICATION FOR  
 PERMITS AND AUTHORIZATIONS FOR BUILDINGS, CONSTRUCTION, AND/OR  
 ZONING CHANGES.

DRAWINGS PREPARED FOR


**CORPORATE  
 REAL ESTATE**

PROJECT TITLE:  
**AST REPLACEMENT**  
 31100 PLYMOUTH ROAD  
 LIVONIA, MI

CLLC M64228

SHEET TITLE:  
**MID LEVEL  
 FLOOR PLAN**

AT&T PROJECT NUMBER: M10057	DATE:	SCALE: NOTED
AT&T AUTHORIZATION:	DRAWN BY: M.N.	CHECKED BY: W.D.
AUTHORIZATION SIGNATURE	SHEET: -- OF: -- SHEETS	SHEET NO. E1.02

v1.0 COPYRIGHT © 2006 by Carter & Burgess Consultants, Inc.